


Appendix 9: As-built Drawing of the fill placed near Containment Pond 6

Total rock placed : 15 653 m3
 Surveyed 2021-07-02



REV	DESCRIPTION	DATE	PAR/BY
REVISIONS			

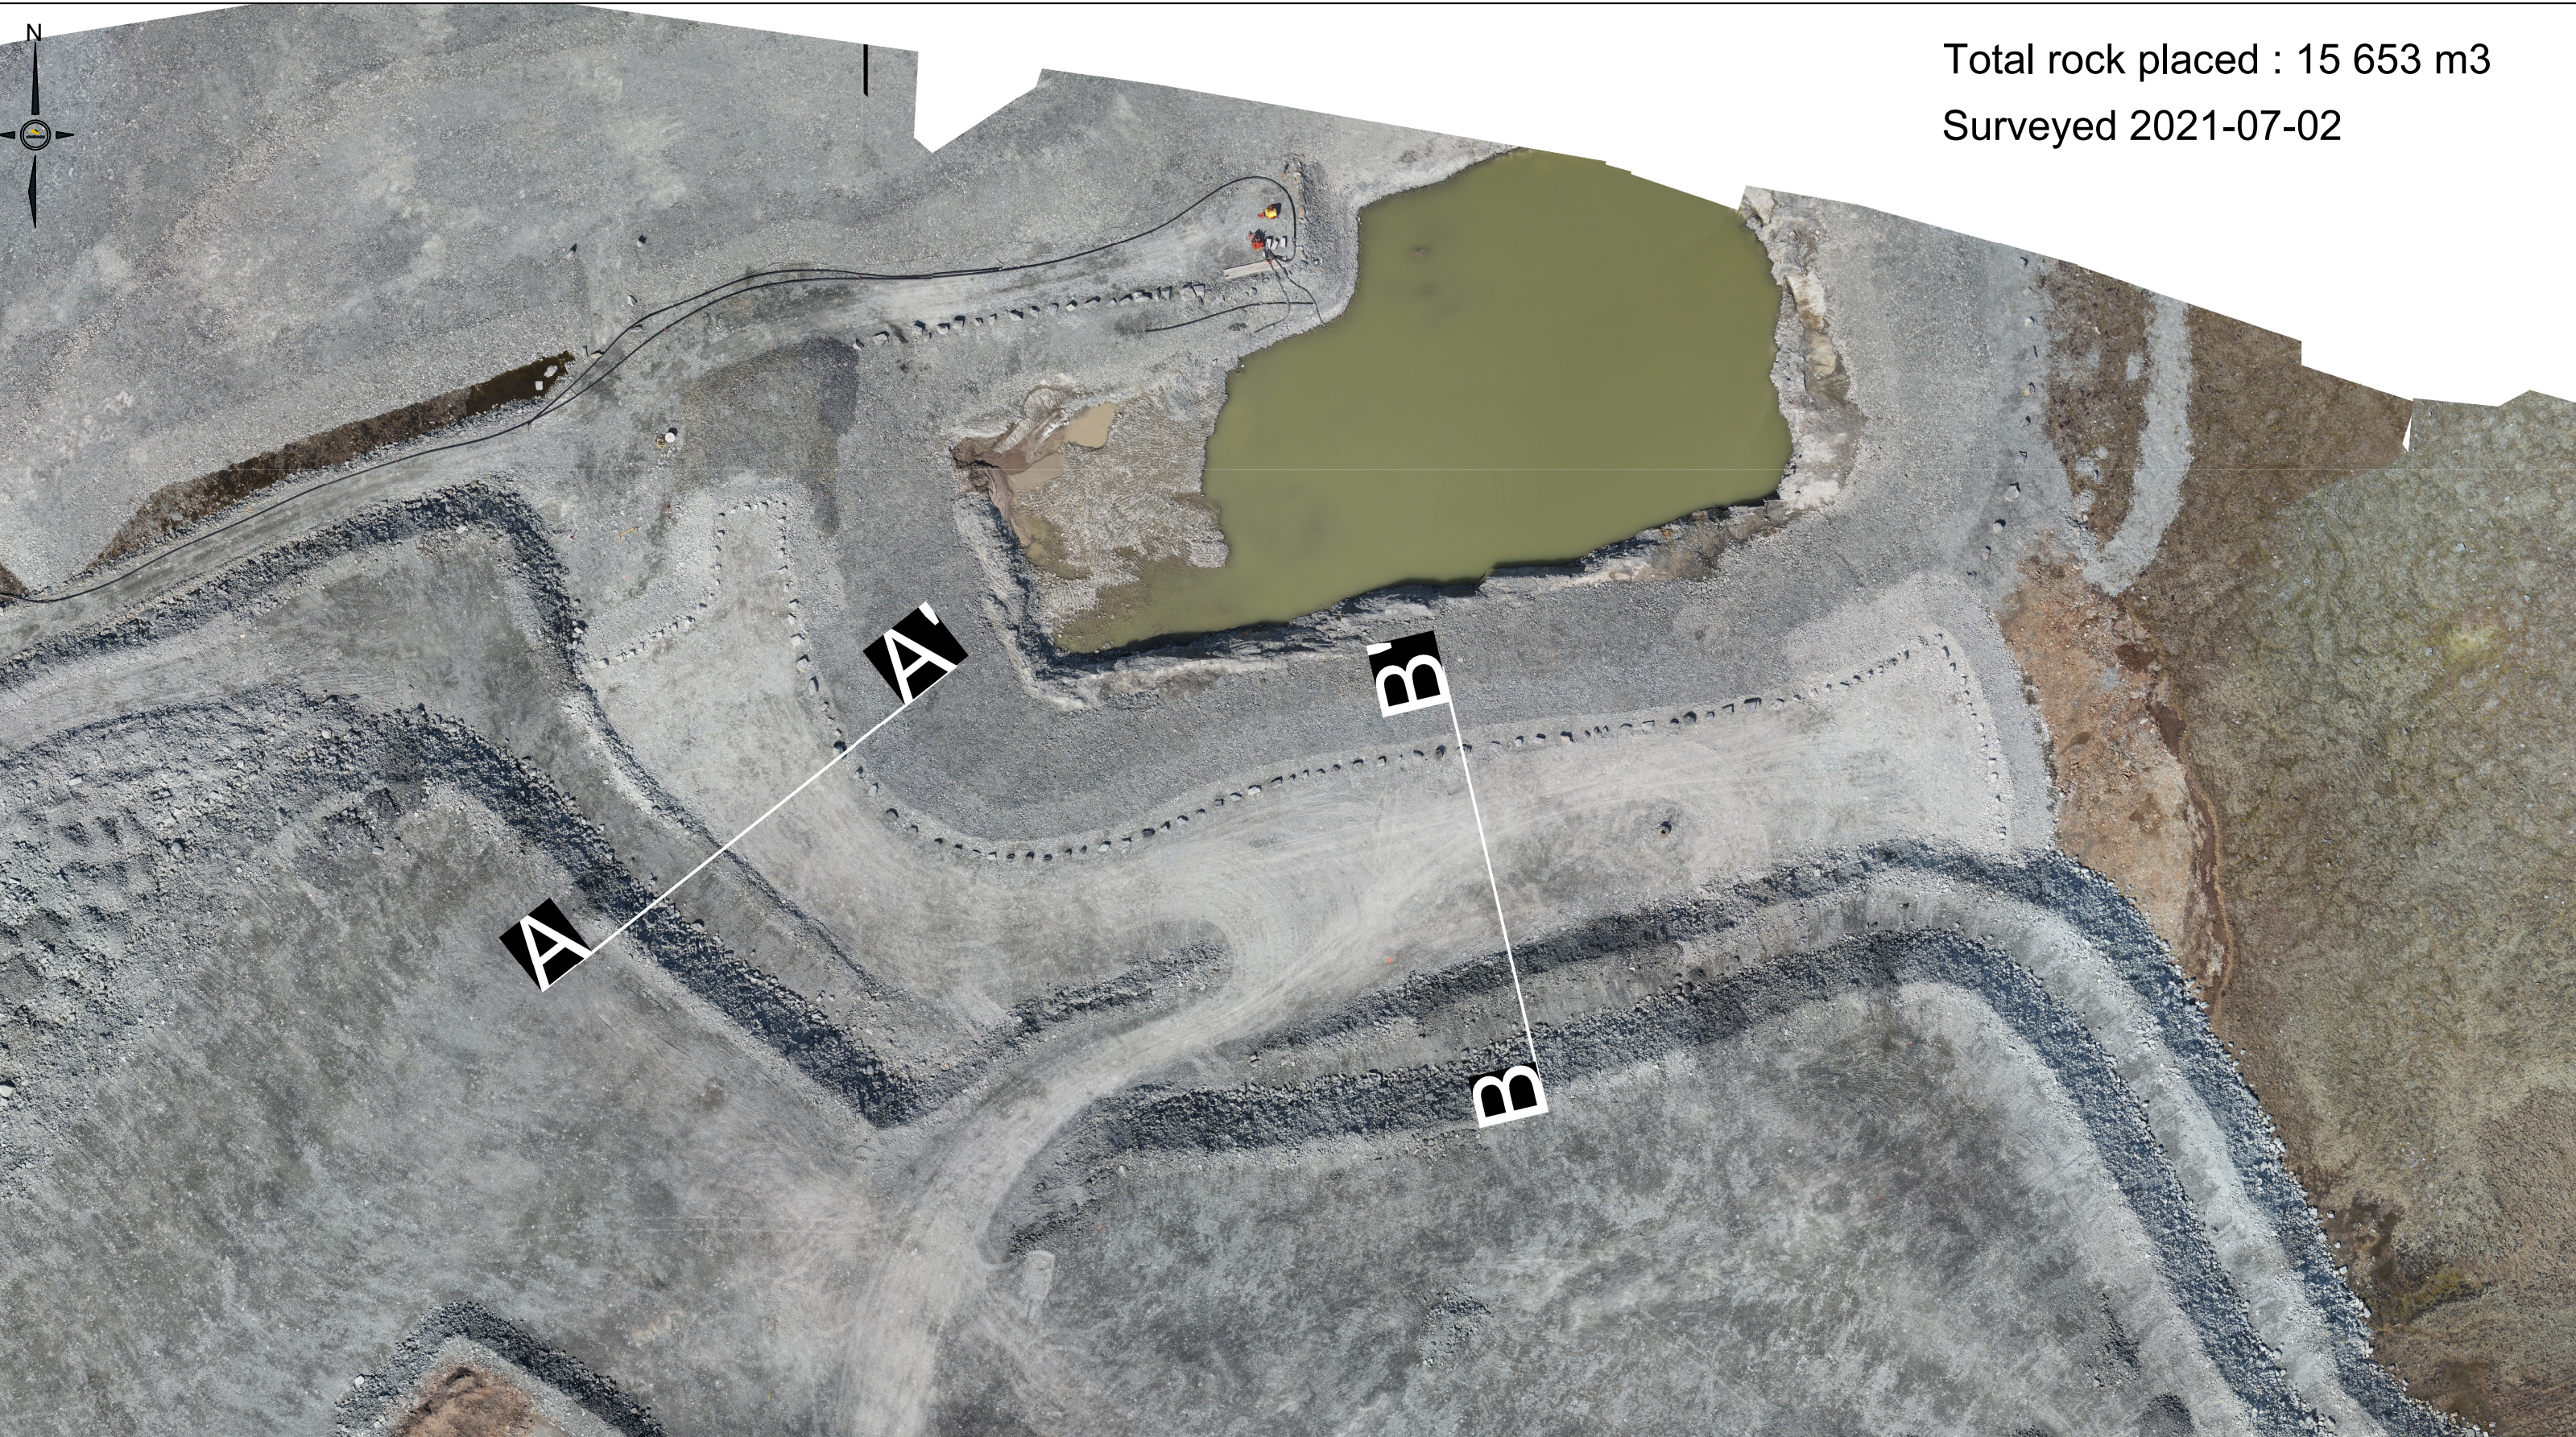

DESSINÉ PAR/DRAWN BY Francis.pepin	DATE 2021/07/03
VERIFIÉ PAR/CHECKED BY	DATE 2021/07/03
APPROUVÉ PAR/APPROVED BY	DATE 2021/07/03
ÉCHELLE/SCALE	FEUILLE/SHT 1/2

TITRE / TITLE AGNICO EAGLE - MELIADINE DIVISION CP6 Rock coverage As built Plan view	
No. DESSIN/DRAWING NO. DRAWING-NO	REVISION A

A

A'

WRSF3

CP6

3.1104

3.0191

B



B'

WRSF3

CP6

2.1656

2.4354

 Drone survey
2021-06-14
 Drone survey
2021-07-02



DESSINÉ PAR/DRAWN BY Francis.pepin	DATE 2021/07/03
VERIFIÉ PAR/CHECKED BY	DATE 2021/07/03
APPROUVÉ PAR/APPROVED BY	DATE 2021/07/03

TITRE / TITLE AGNICO EAGLE - MELIADINE DIVISION CP6 Rockfill coverage As built Cross sections

ÉCHELLE/SCALE
<<Scale[]>>

FEUILLE/SHT
2/2

No. DESSIN/DRAWING NO.
DRAWING-NO

REVISION
A

REV	DESCRIPTION	DATE	PAR/BY
REVISIONS			