


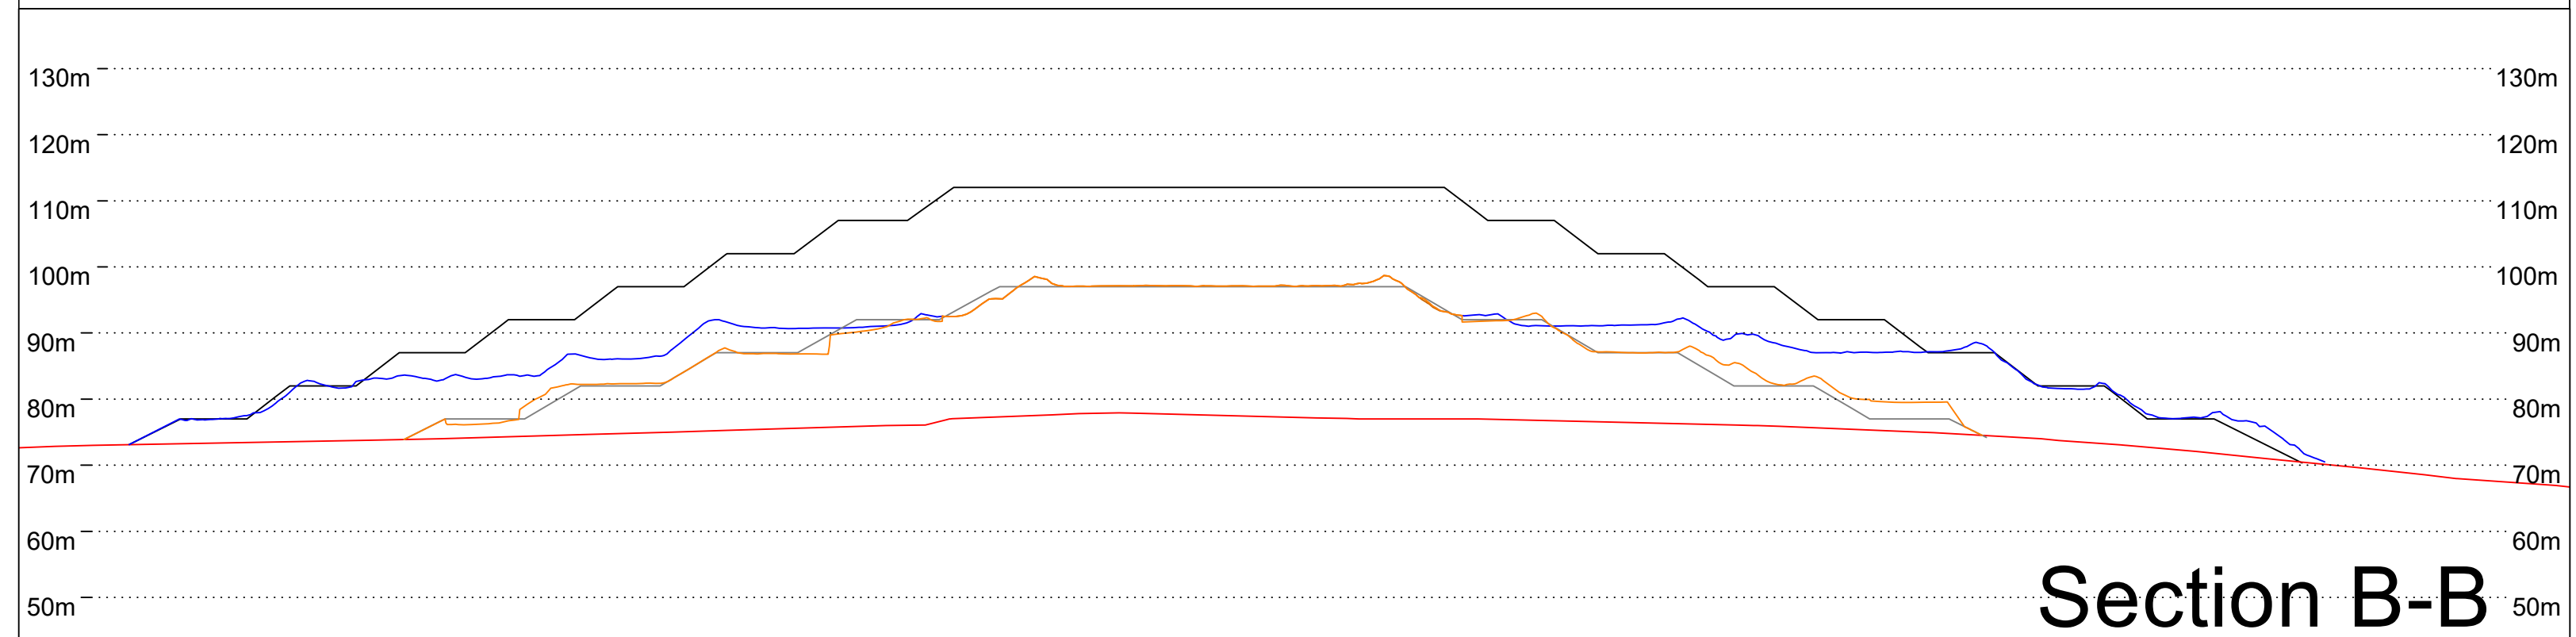
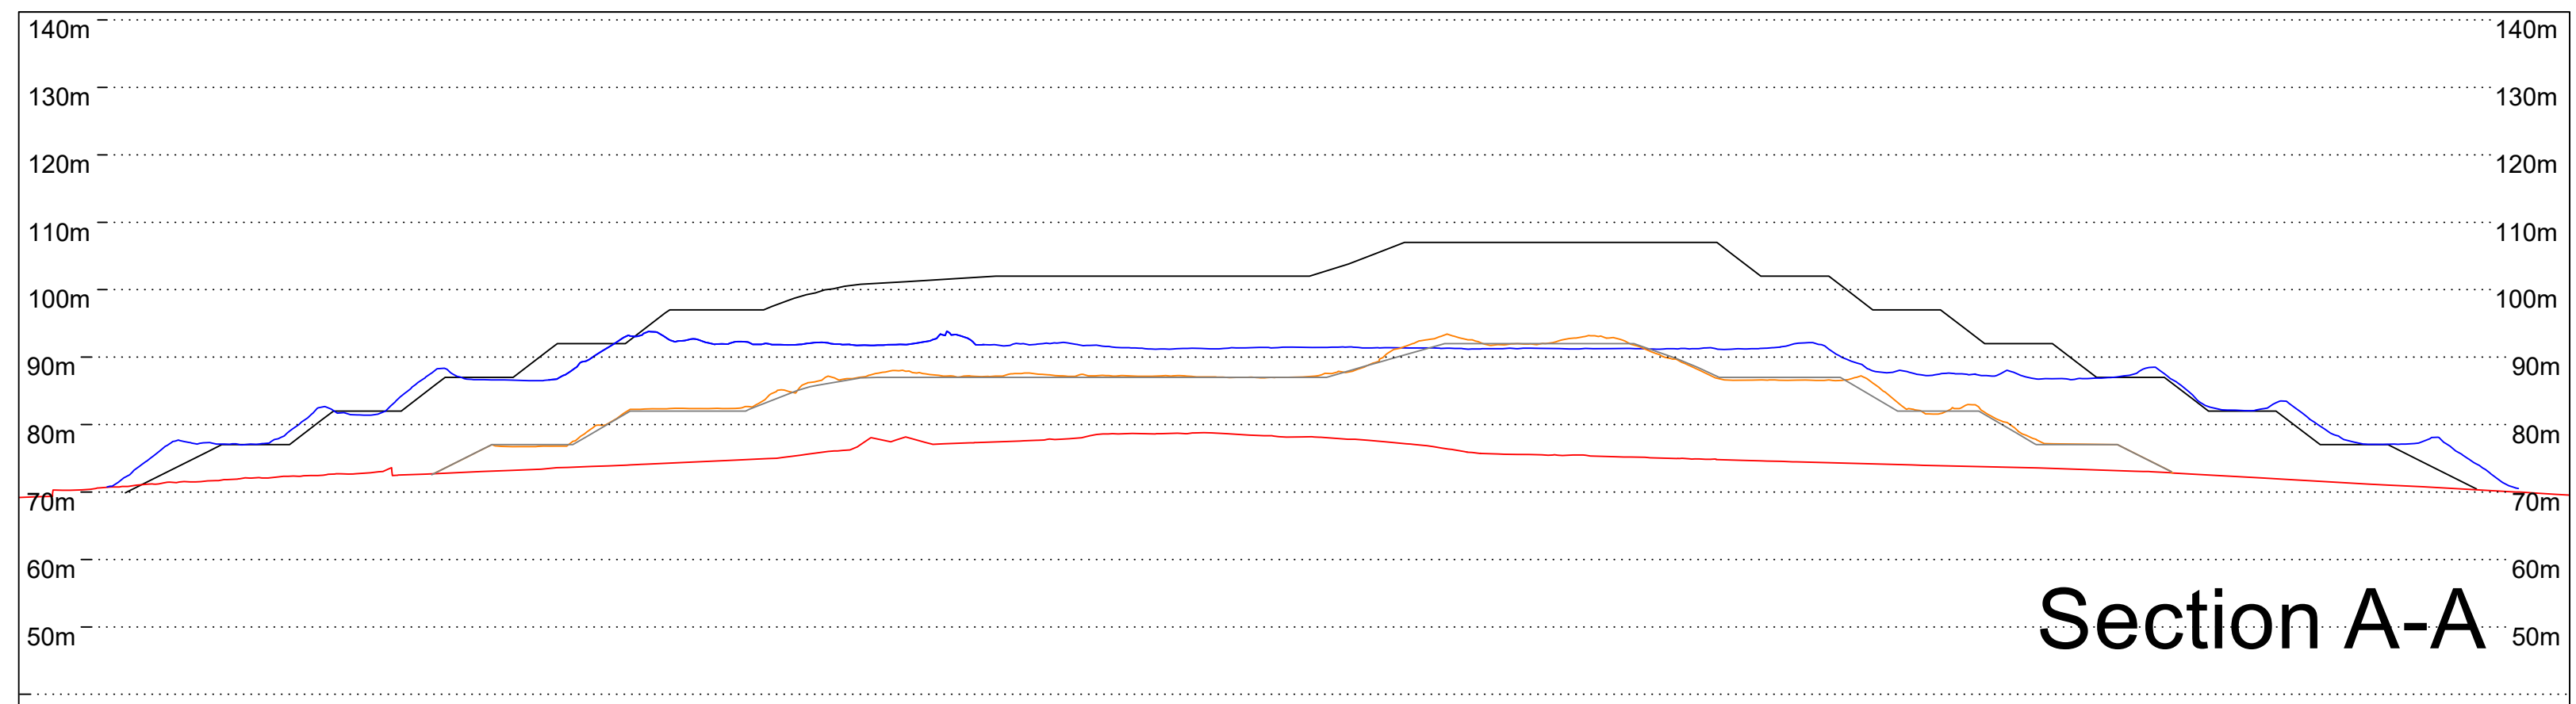


Appendix 12: WRSF1 and WRSF3 Plans and Sections

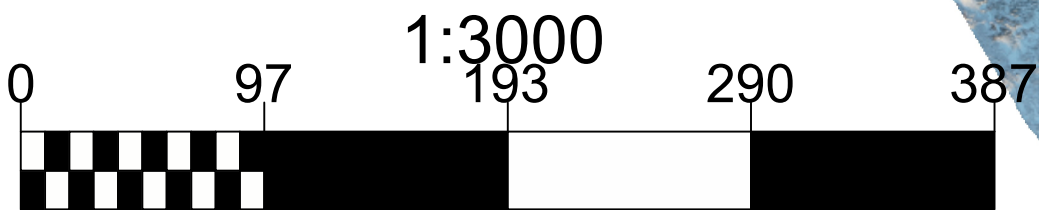

REV	DESCRIPTION	DATE	BY
REVISIONS			

 AGNICO EAGLE MELIADINE	DRAWN BY Alice Buttet-Allard	DATE 3/16/2022	TITLE AGNICO EAGLE - MELIADINE WRSF1 PLAN 2021	
	CHECKED BY	DATE		
	APPROVED BY	DATE		
	SCALE 1:3000	SHEET 1/2	DRAWING NO.	REVISION A

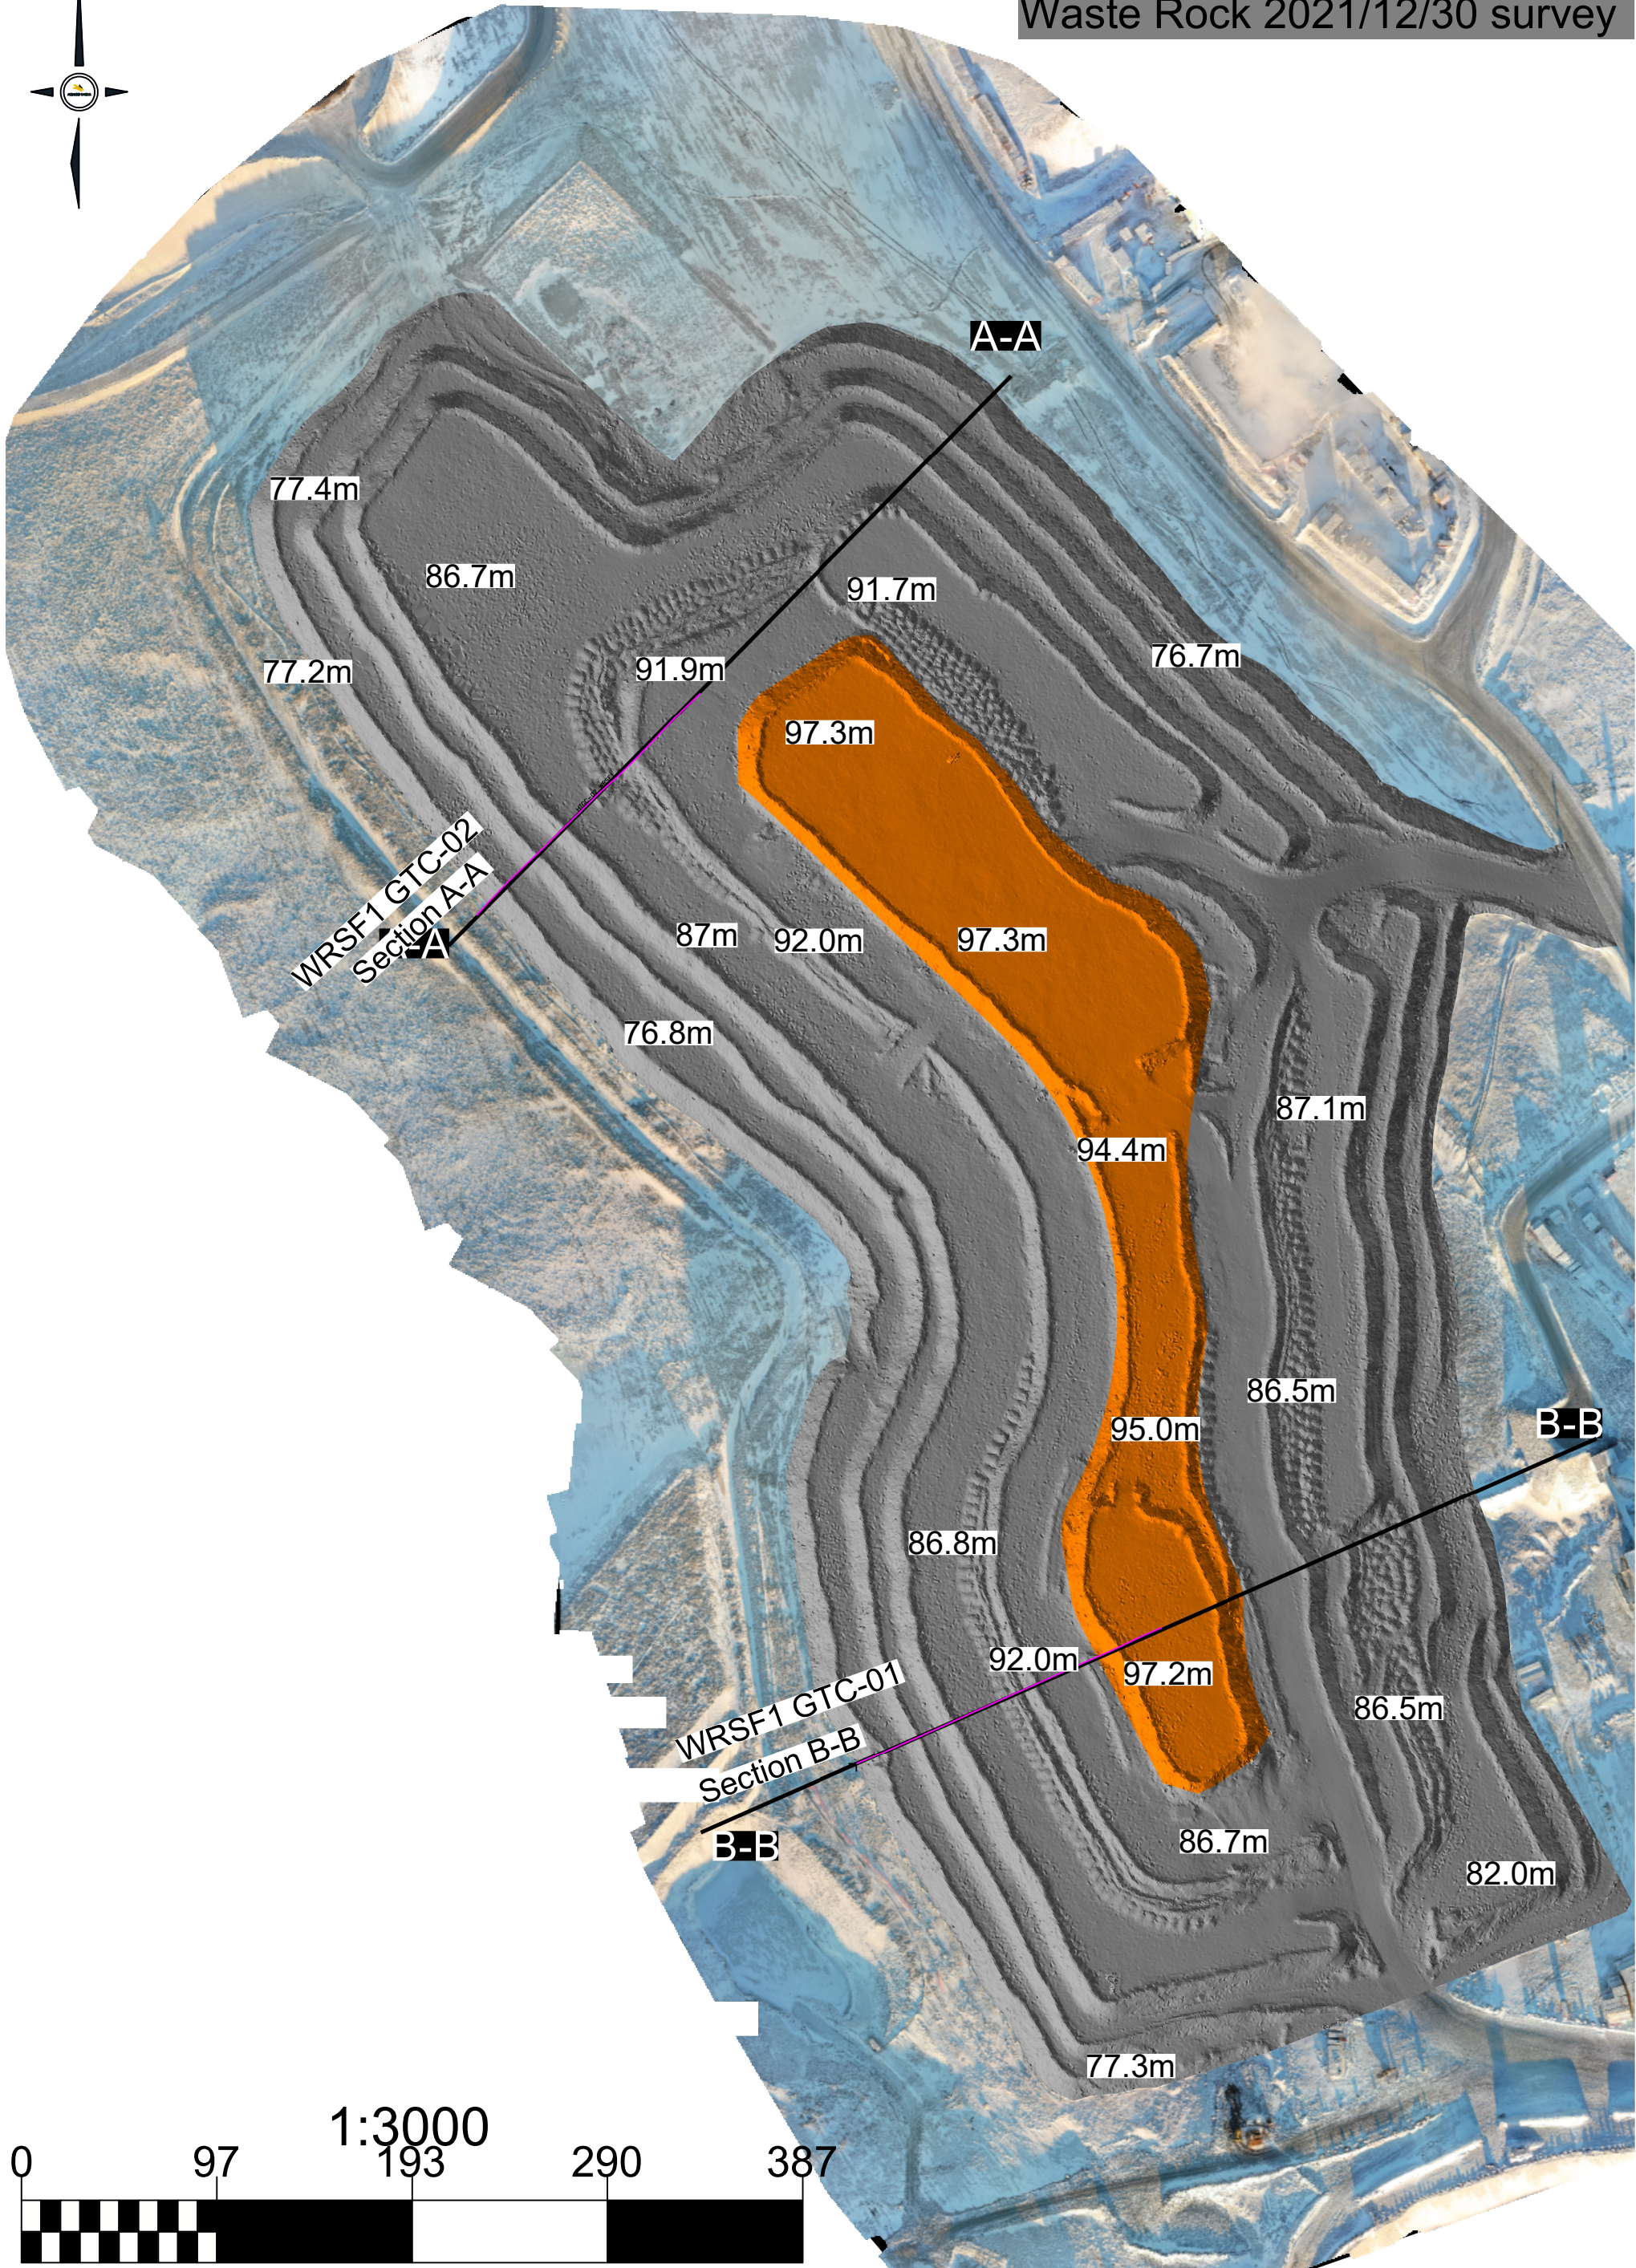


- Waste Rock As-Built
- Overburden As-Built
- Design Waste Rock
- Design Overburden
- Original Ground



DESSINÉ PAR/DRAWN BY Enrick Dufour		DATE 2021/12/31	TITRE / TITLE AGNICO EAGLE - MELIADINE DIVISION WRSF1 CROSS SECTIONS 2021		
VÉRIFIÉ PAR/CHECKED BY		DATE			
APPROUVÉ PAR/APPROVED BY		DATE			
		ÉCHELLE/SCALE	FEUILLE/SHT 2/2	No. DESSIN/DRAWING NO.	REVISION A

REV	DESCRIPTION	DATE	PAR/BY
REVISIONS			

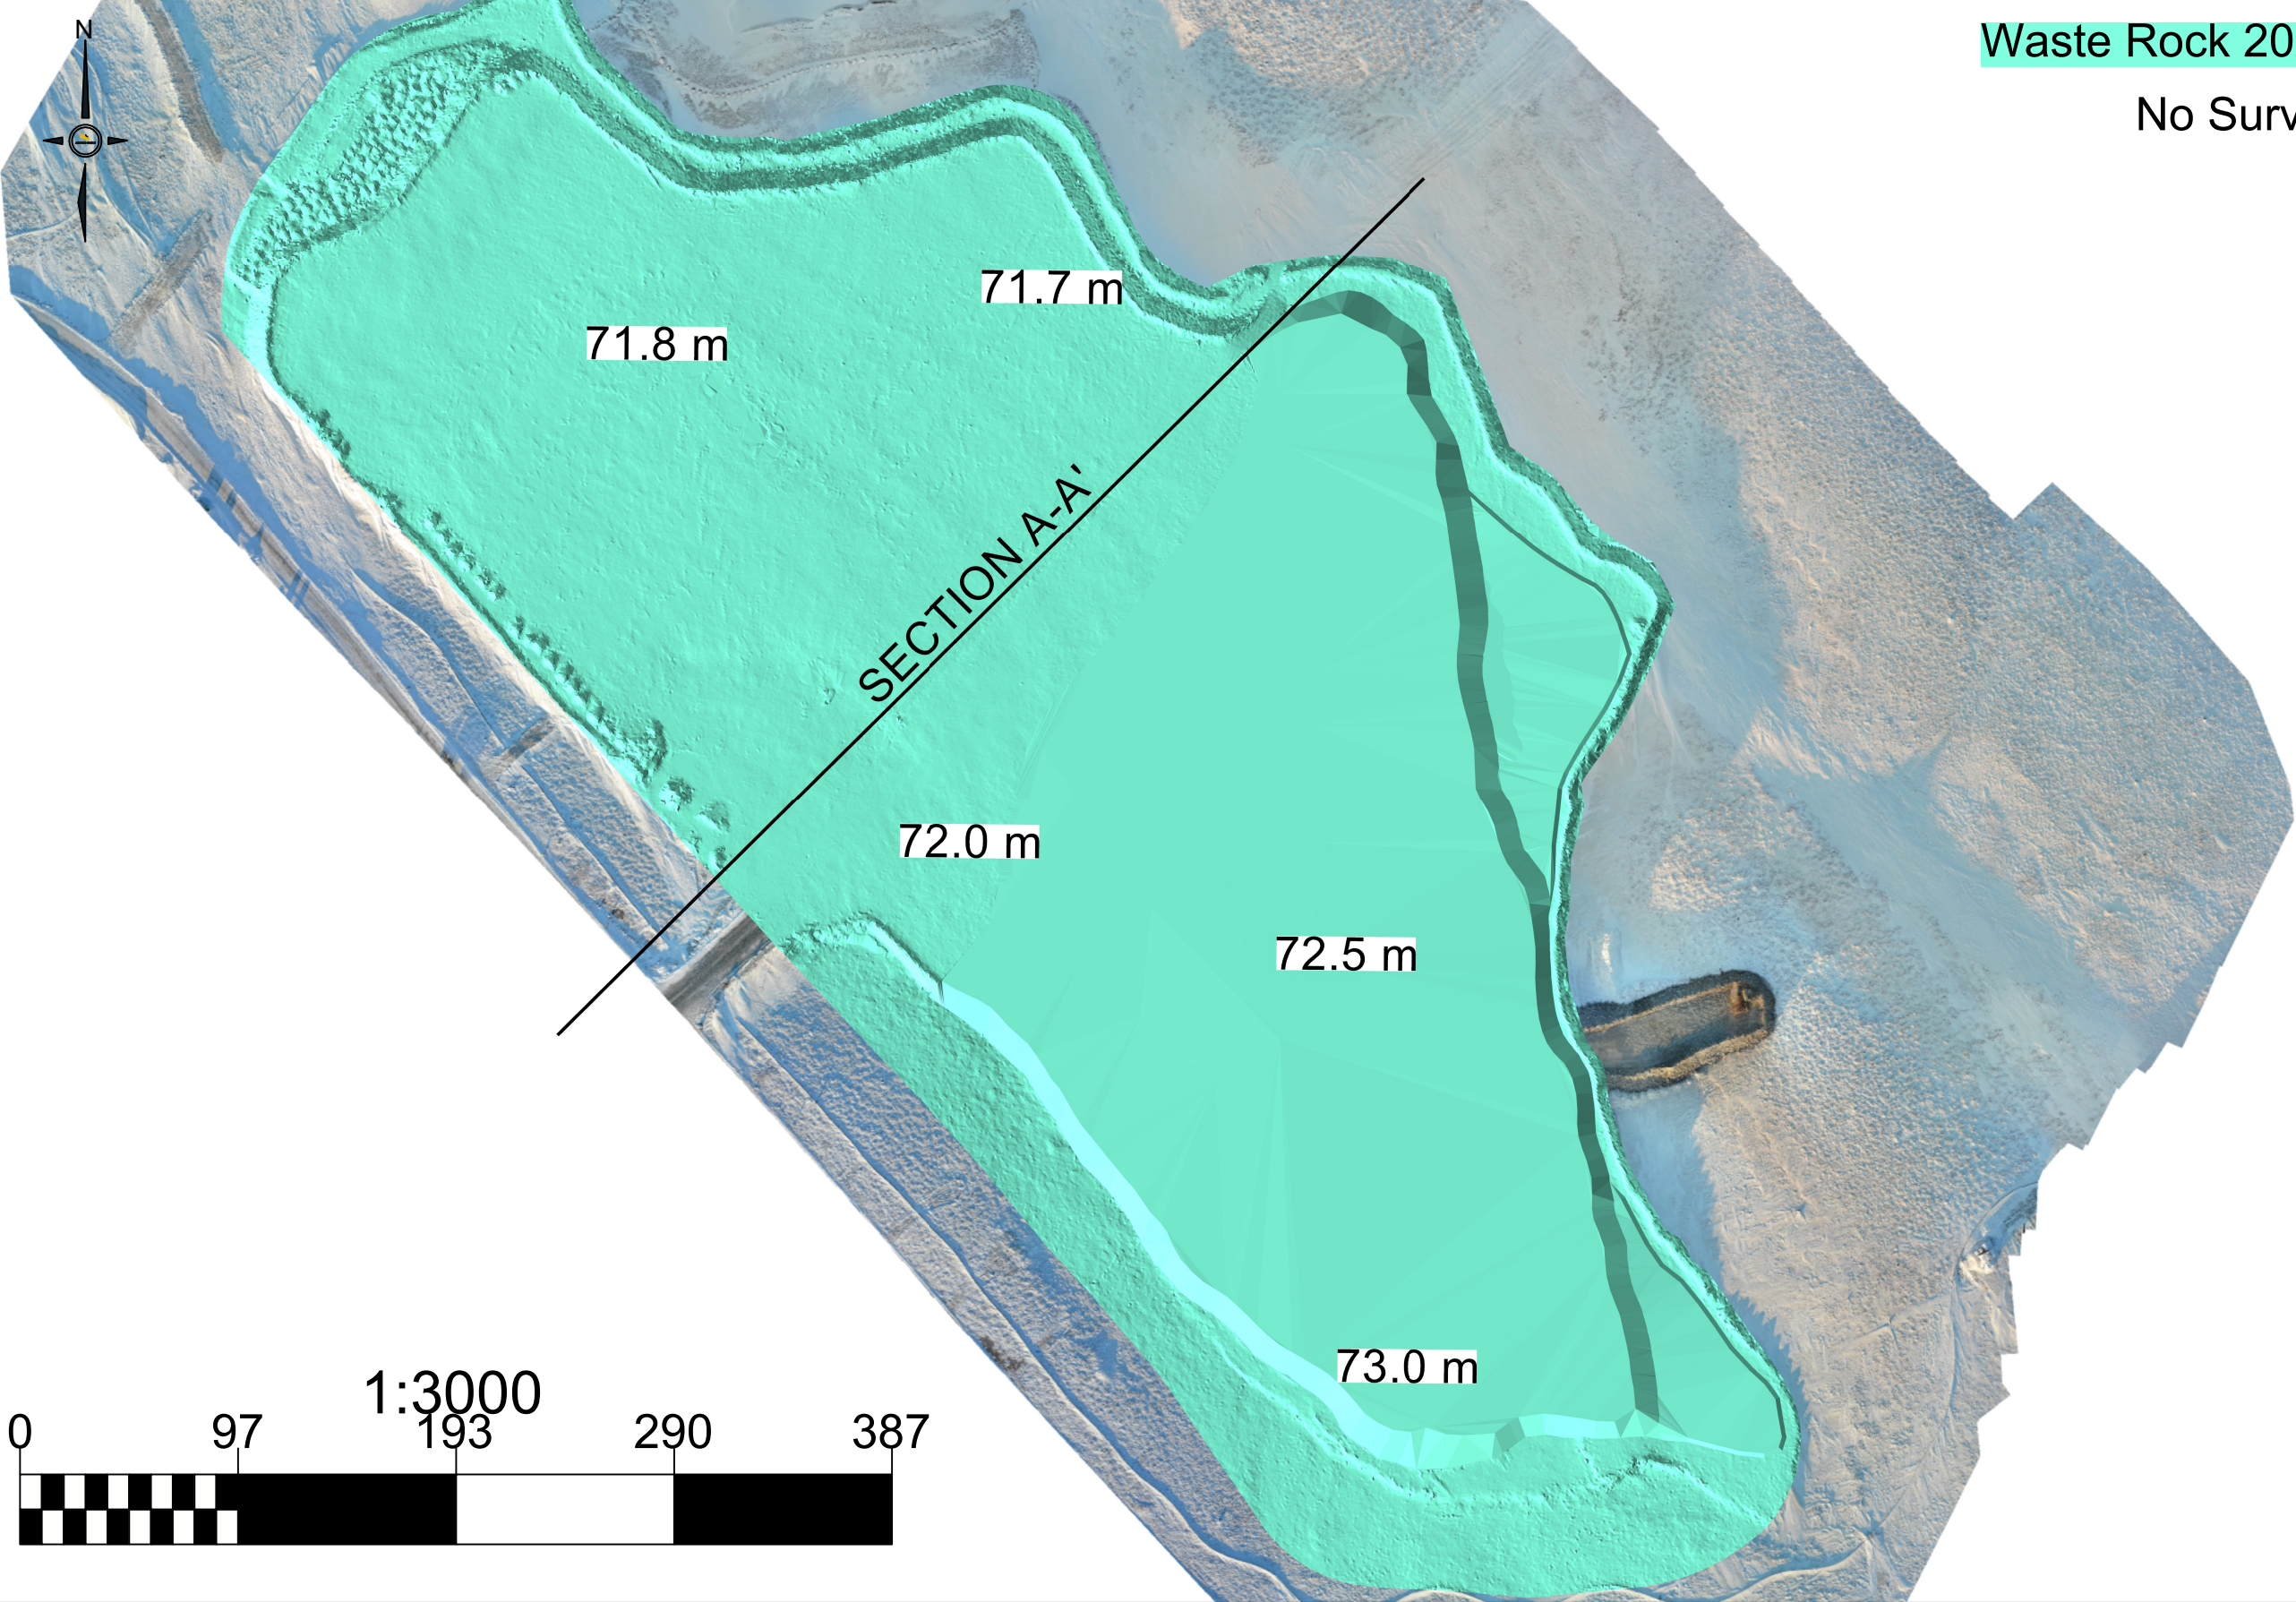

REV	DESCRIPTION	DATE	PAR/BY
REVISIONS			




DESSINÉ PAR/DRAWN BY Alice Buttet-Allard	DATE 2022/02/27
VERIFIÉ PAR/CHECKED BY	DATE
APPROUVÉ PAR/APPROVED BY	DATE
ÉCHELLE/SCALE 1:3000	FEUILLE/SHT 1/1

AGNICO EAGLE - MELIADINE DIVISION WRSF3 PLAN 2021	
No. DESSIN/DRAWING NO. DRAWING-NO	REVISION A

A

A'

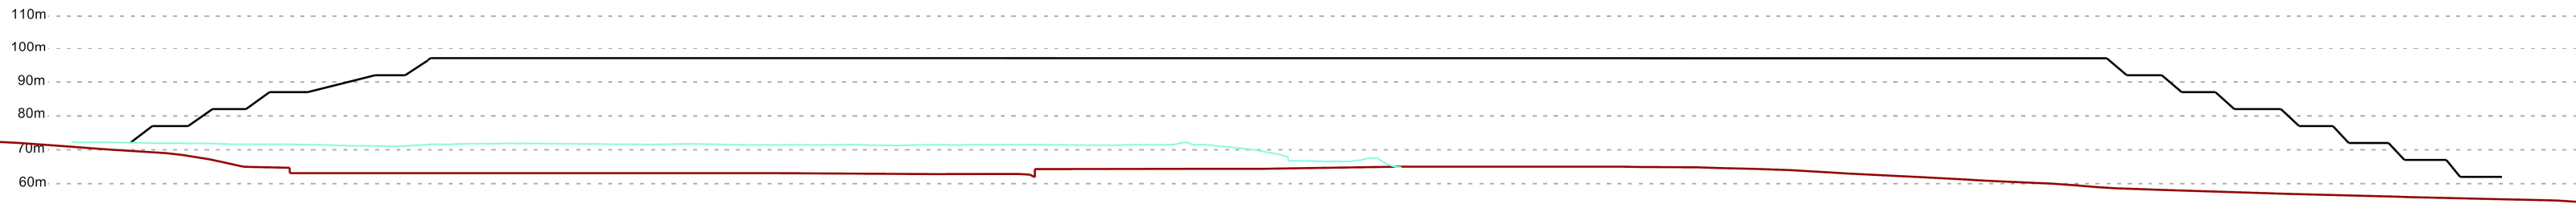

- Design WRSF3 Extension
- 2021 WRSF3
- Topography



DESSINÉ PAR/DRAWN BY Alice Buttet-Allard	DATE 16/03/2022	
VÉRIFIÉ PAR/CHECKED BY	DATE	
APPROUVÉ PAR/APPROVED BY	DATE	
	ECHELLE/SCALE 1:1800	FEUILLE/SHT 1/1

TITRE / TITLE AGNICO EAGLE - MELIADINE DIVISION WSF3 WRSF3 2021 CROSS SECTION	REVISION A
No. DESSIN/DRAWING NO	

REV	DESCRIPTION	DATE	PAR/BY
REVISIONS			